OFFICE OF THE MARION COUNTY SURVEYOR
SECTION RECORD CORNER
SECTION 36 TOWNSHIP 17 RANGE 4
DATE: 9-30-02
PARTY CHIEF: Wilcoxen
CREW:
TYPE OF MARKER: 4"x4" concrete monu. w/'x'
METHOD OF ESTABLISHMENT: County: 11-26-96

IN. S.P.C. E ZONE NAD '83
NAME: 17043608
N: 513046.5799(m)
E: 69465.4522(m)

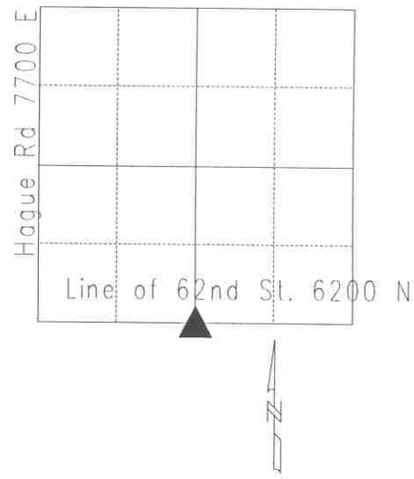

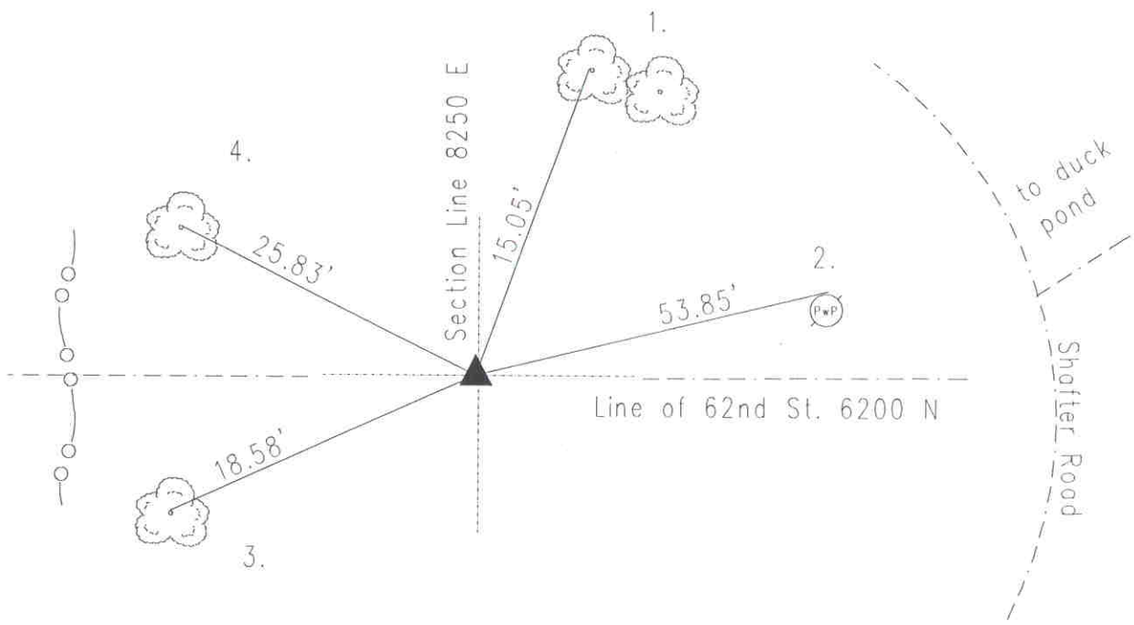

Fort Benjamin State Park

17043608

REF.	DISTANCE	DESCRIPTION
1.	15.05'	Boat spike W twin sycamore 6"up
2.	53.85'	PK nail N PwP#129-320 18"up
3.	18.58'	Boat spike N 20" hackberry 18"up
4.	25.83'	Boat spike NE 24" cottonwood 24"up