OFFICE OF THE MARION COUNTY SURVEYOR
SECTION RECORD CORNER
SECTION 19 TOWNSHIP 17 RANGE 5
DATE: 10-26-99
PARTY CHIEF: Kiste
CREW:
TYPE OF MARKER: Railroad spike set
METHOD OF ESTABLISHMENT: County: 4-28-94

Note: 10-13-1982 dug by Wilcoxen found 1" lead pipe; set railroad spike over pipe.

NOTE: This corner position represents a title corner and may not necessarily be in the position of the Record corner.

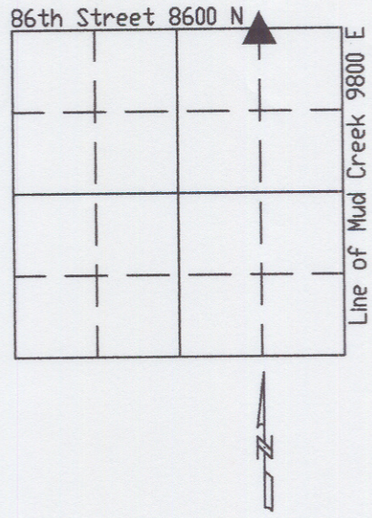

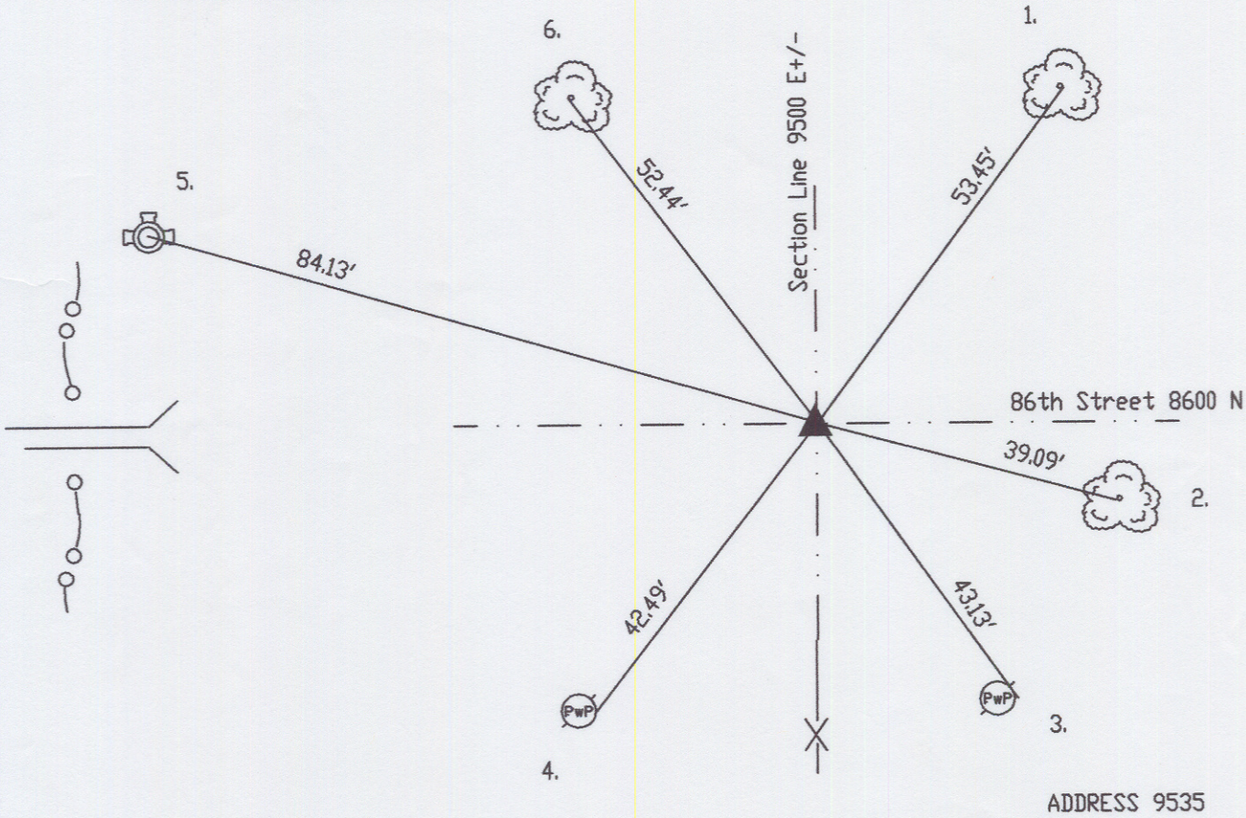

SX751911

REF.	DISTANCE	DESCRIPTION
1.	53.45'	Railroad spike E 36" twin poplar 5'up
2.	39.09'	PK nail w/shiner W 10" oak 24"up
3.	43.13'	#58 date nail E PwP#2-221BB 24"up
4.	42.49'	Road nail E PwP#89-221DB 14"up
5.	84.13'	Top nut of fire hydrant
6.	52.44'	Railroad spike SW 24" cottonwood