OFFICE OF THE MARION COUNTY SURVEYOR
SECTION RECORD CORNER
SECTION 29 TOWNSHIP 17 RANGE 5
DATE: ~~7-13-98~~ -- 6-11-03
PARTY CHIEF: Wilcoxen
CREW:
TYPE OF MARKER: Note:
METHOD OF ESTABLISHMENT: County: 2-7-94

IN. S.P.C. E ZONE, NAD 83
NAME: 17052901
N: 516257.2596(m)
E: 71911.3952(m)
NOTE: Capped rebar set 0.2'+/- W-back of curb:

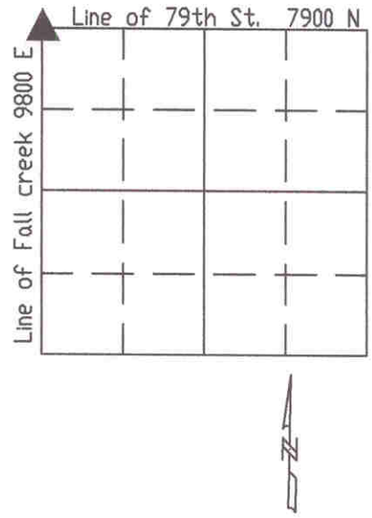

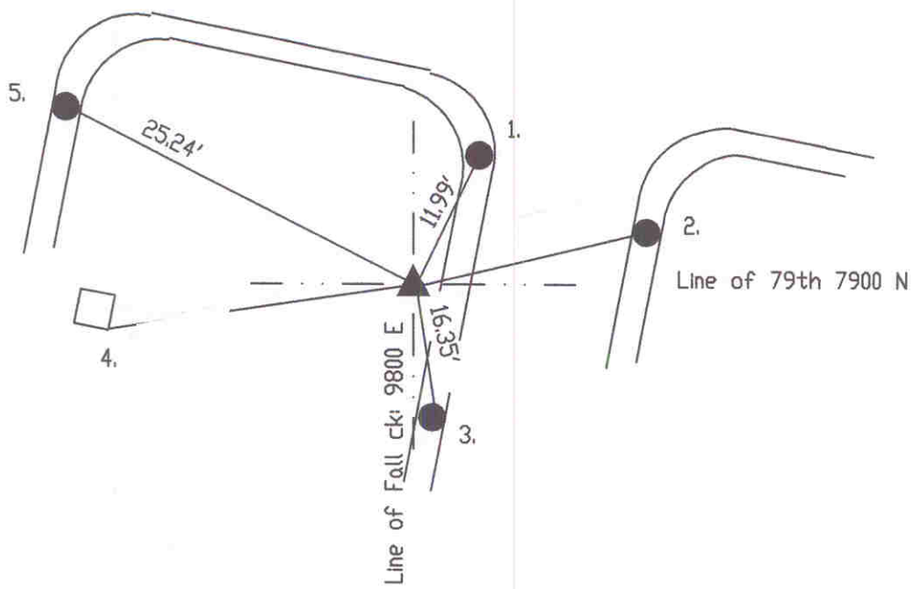

Original post set 1821 by Laughlin with witnesses: 6" buckeye N 16 W 20 links, 6" buckeye S 80 E 11 links per Marion County Atlas. 8-1854 Wilson survey per Lawrence Township legal Survey Book pg. 9 & 10 called stone. 10-1874 Voorhis per Lawrence Township Legal Survey Book pg. 13 no mention of corner itself. Stone is labelled "M" to the E, and labelled "C" to the S. 4-1879 Fatout per Lawrence Township Legal Survey Book pg. 37 called same. 11-22-77 Smith MCSD called PK nail. Info per Cripe Jobs#80220 & 79110 called PK nail per County ties. Excavated 7-15-82 by Cleveland. 2'x2' hole dug 30" deep. PK nail at surface Harrison set. Re-tied 7-13-98.

HC752901

REF.	DISTANCE	DESCRIPTION
1.	11.99'	PK w/brass washer curb joint
2.	25.43'	PK w/brass washer curb joint
3.	16.35'	PK w/brass washer curb joint
4.	32.84'	Top corner MAC metal box
5.	25.24'	PK w/brass washer curb joint