OFFICE OF THE MARION COUNTY SURVEYOR
SECTION RECORD CORNER
SECTION 30 TOWNSHIP 17 RANGE 5
DATE: 1-25-2000
PARTY CHIEF: Kiste
CREW:
TYPE OF MARKER: 6"x6" concrete monument
METHOD OF ESTABLISHMENT: County: 3-11-94

IN. S.P.C. E ZONE, NAD 83
NAME: 17053005
N: 515456.7322(m)
E: 71091.1643(m)

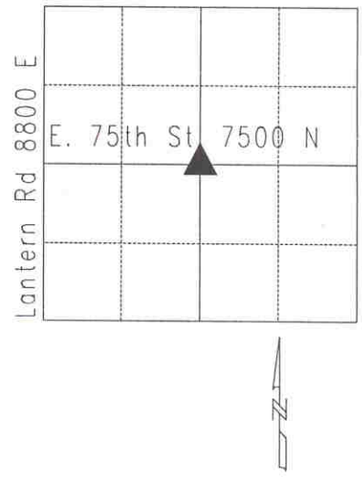

THIS CORNER POSITION REPRESENTS A "TITLE" CORNER AND MAY NOT NECESSARILY REPRESENT THE POSITION BASED ON RECORD CORNERS.

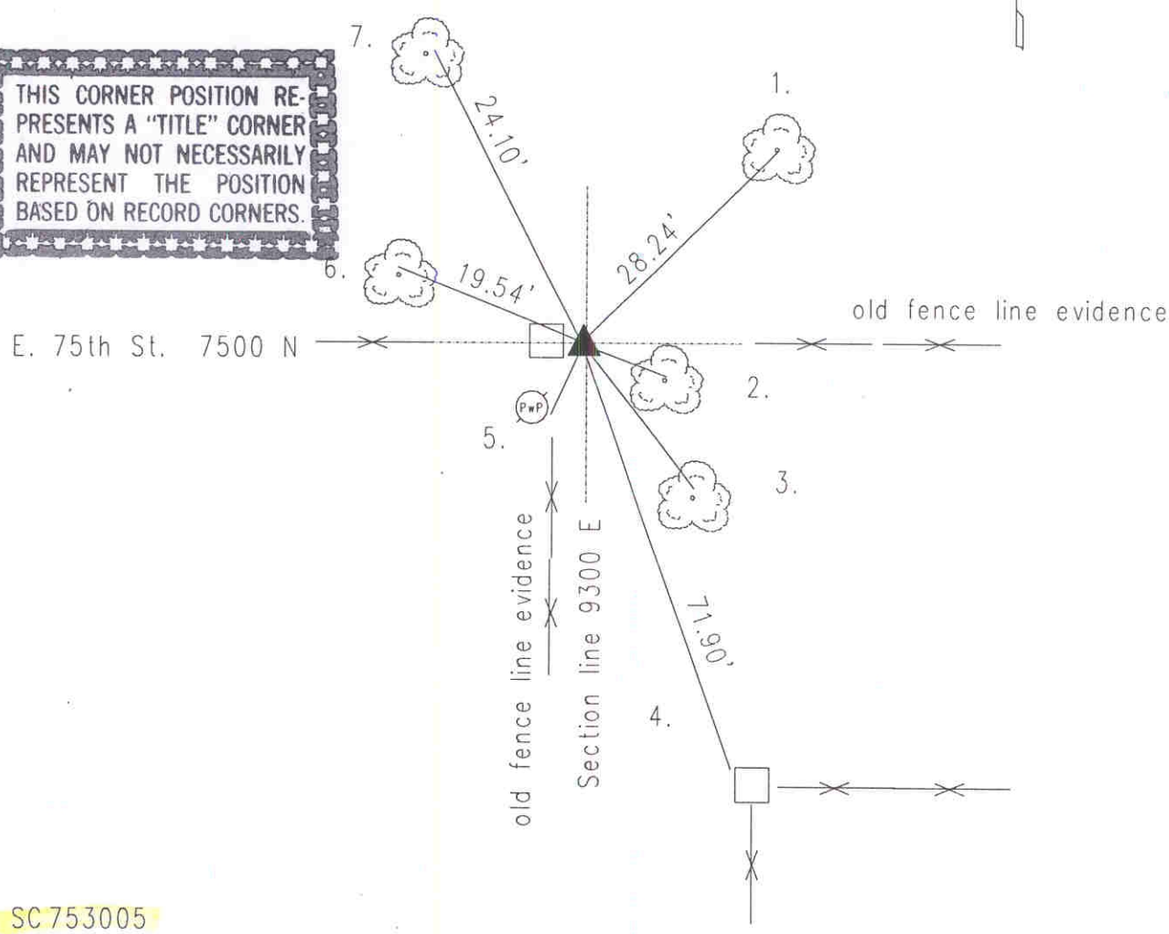

SC753005

REF.	DISTANCE	DESCRIPTION
1.	28.24'	PK nail S 24" ash 48"up
2.	7.55'	PK nail N 12" walnut 8"up
3.	26.42'	PK nail E 24" ash 48"up
4.	71.90'	NW corner of fence post for 'pool area' #9246 Sandbury La
5.	2.51'	PK nail SE PwP#78-281AA 60"up
6.	19.54'	Mag nail w/washer N 24" ash 60"up
7.	24.10'	PK nail w/shiner E 24" ash 24"up