OFFICE OF THE MARION COUNTY SURVEYOR
SECTION RECORD CORNER
SECTION 34 TOWNSHIP 17 RANGE 5
DATE: ~~4-17-02~~ 11-16-07
PARTY CHIEF: Wilcoxen
CREW:
TYPE OF MARKER: Harrison FD
METHOD OF ESTABLISHMENT: County: 2-18-79

IN. S.P.C. E ZONE NAD '83
NAME: 17053404
N: 513884.2890(m)
E: 75154.7410(m)

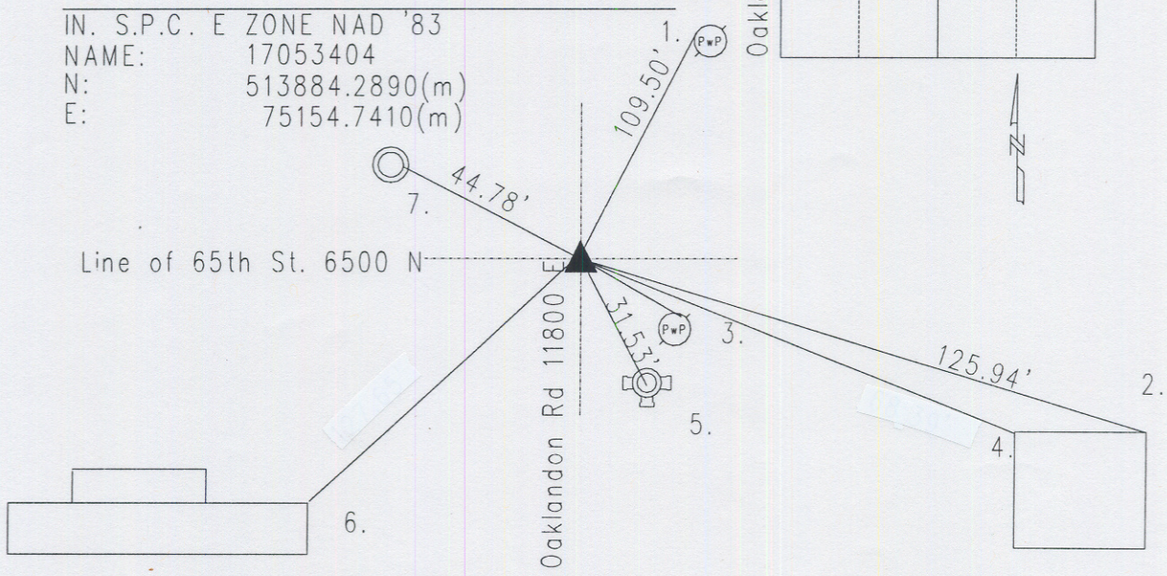

Original post set 1821 by Laughlin with witness: 12" white oak N 72 W 11 links; 12" beech S 66 E 36 links. Legal 2-1849 Hosbrook per Lawrence Township Legal' Survey Book pg. 16 & 41 called corner 'K' and stone. Distance given to the N. Legal 1877 or 1880 by Fatout per Lawrence Township Legal Survey Book pg. 40. called distance to W & S but did no described corner. Legal 1-1931 called corner 'C' and called it an iron pin. Distances given N & W. Seward 1-1952 gives ties but didn't describe corner. Another undated tie called a PK nail at surface. Two tie cards described same position. 6-23-75 Fortner called a PK nail. 1975 tie can be correlated with the undated cards as describing the same location. Excavated 8-17-82, 2'x2' hole dug 26" dn. PK nail fd at surface 6-1975. Large spike (12" x1 1/2" in diameter fd 8" dn. 0.07' SW of PK. Stone 15"x8" w/hi-pt fd 26" dn. Hi-pt was 0.17' NE of PK.Stone left in in place. Harrison set flush over stone's high point. Re-tied 2-18-97 by Wilcoxen. Re-tied 4-17-02 by Wilcoxen. 17023404

REF.	DISTANCE	DESCRIPTION
1.	109.50'	PK nail W PwP#52-281F 12"up
2.	125.94'	NE block "Fire Station"
3.	24.93'	PK nail NE PwP#80-321 F 10"up
4.	68.31'	NW "Fire Station" block
5.	31.53'	Top nut of fire hydrant
6.	128.19'	NE wood for "Jazzersize"
7.	44.78'	Cut 'x' E-edge of telephone manhole rim